



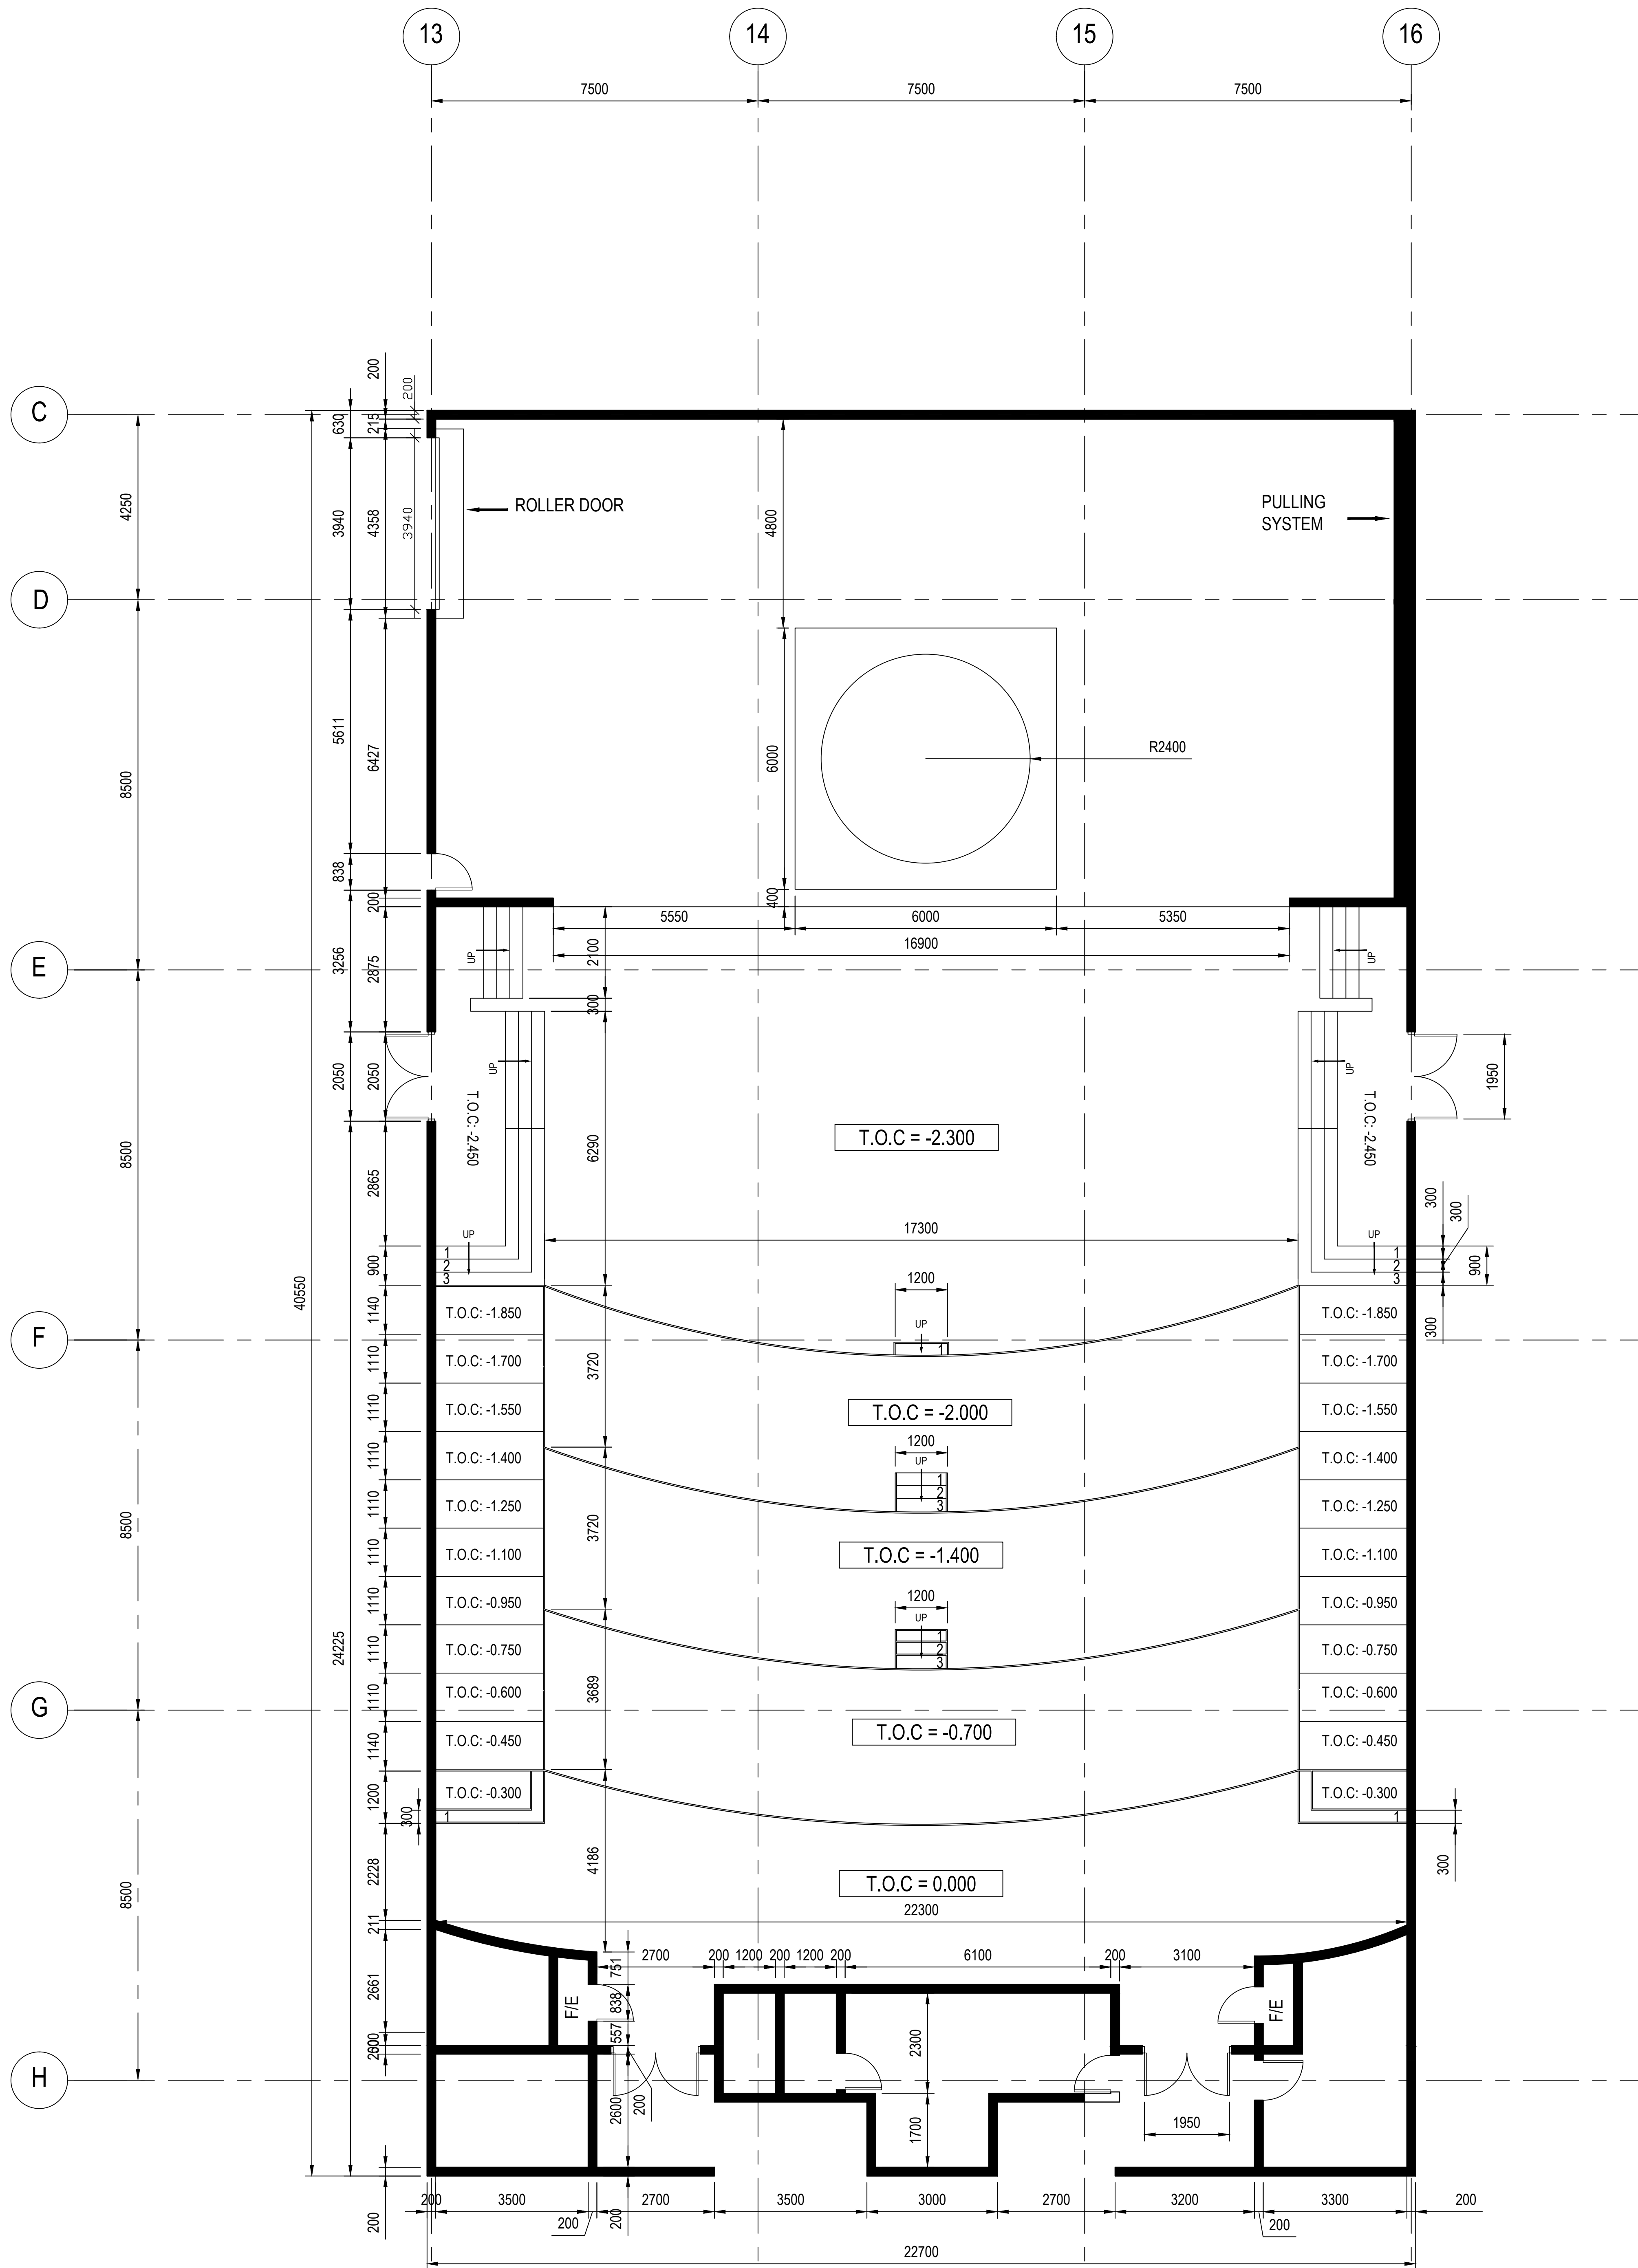

AUDITORIUM
SCALE 1:100

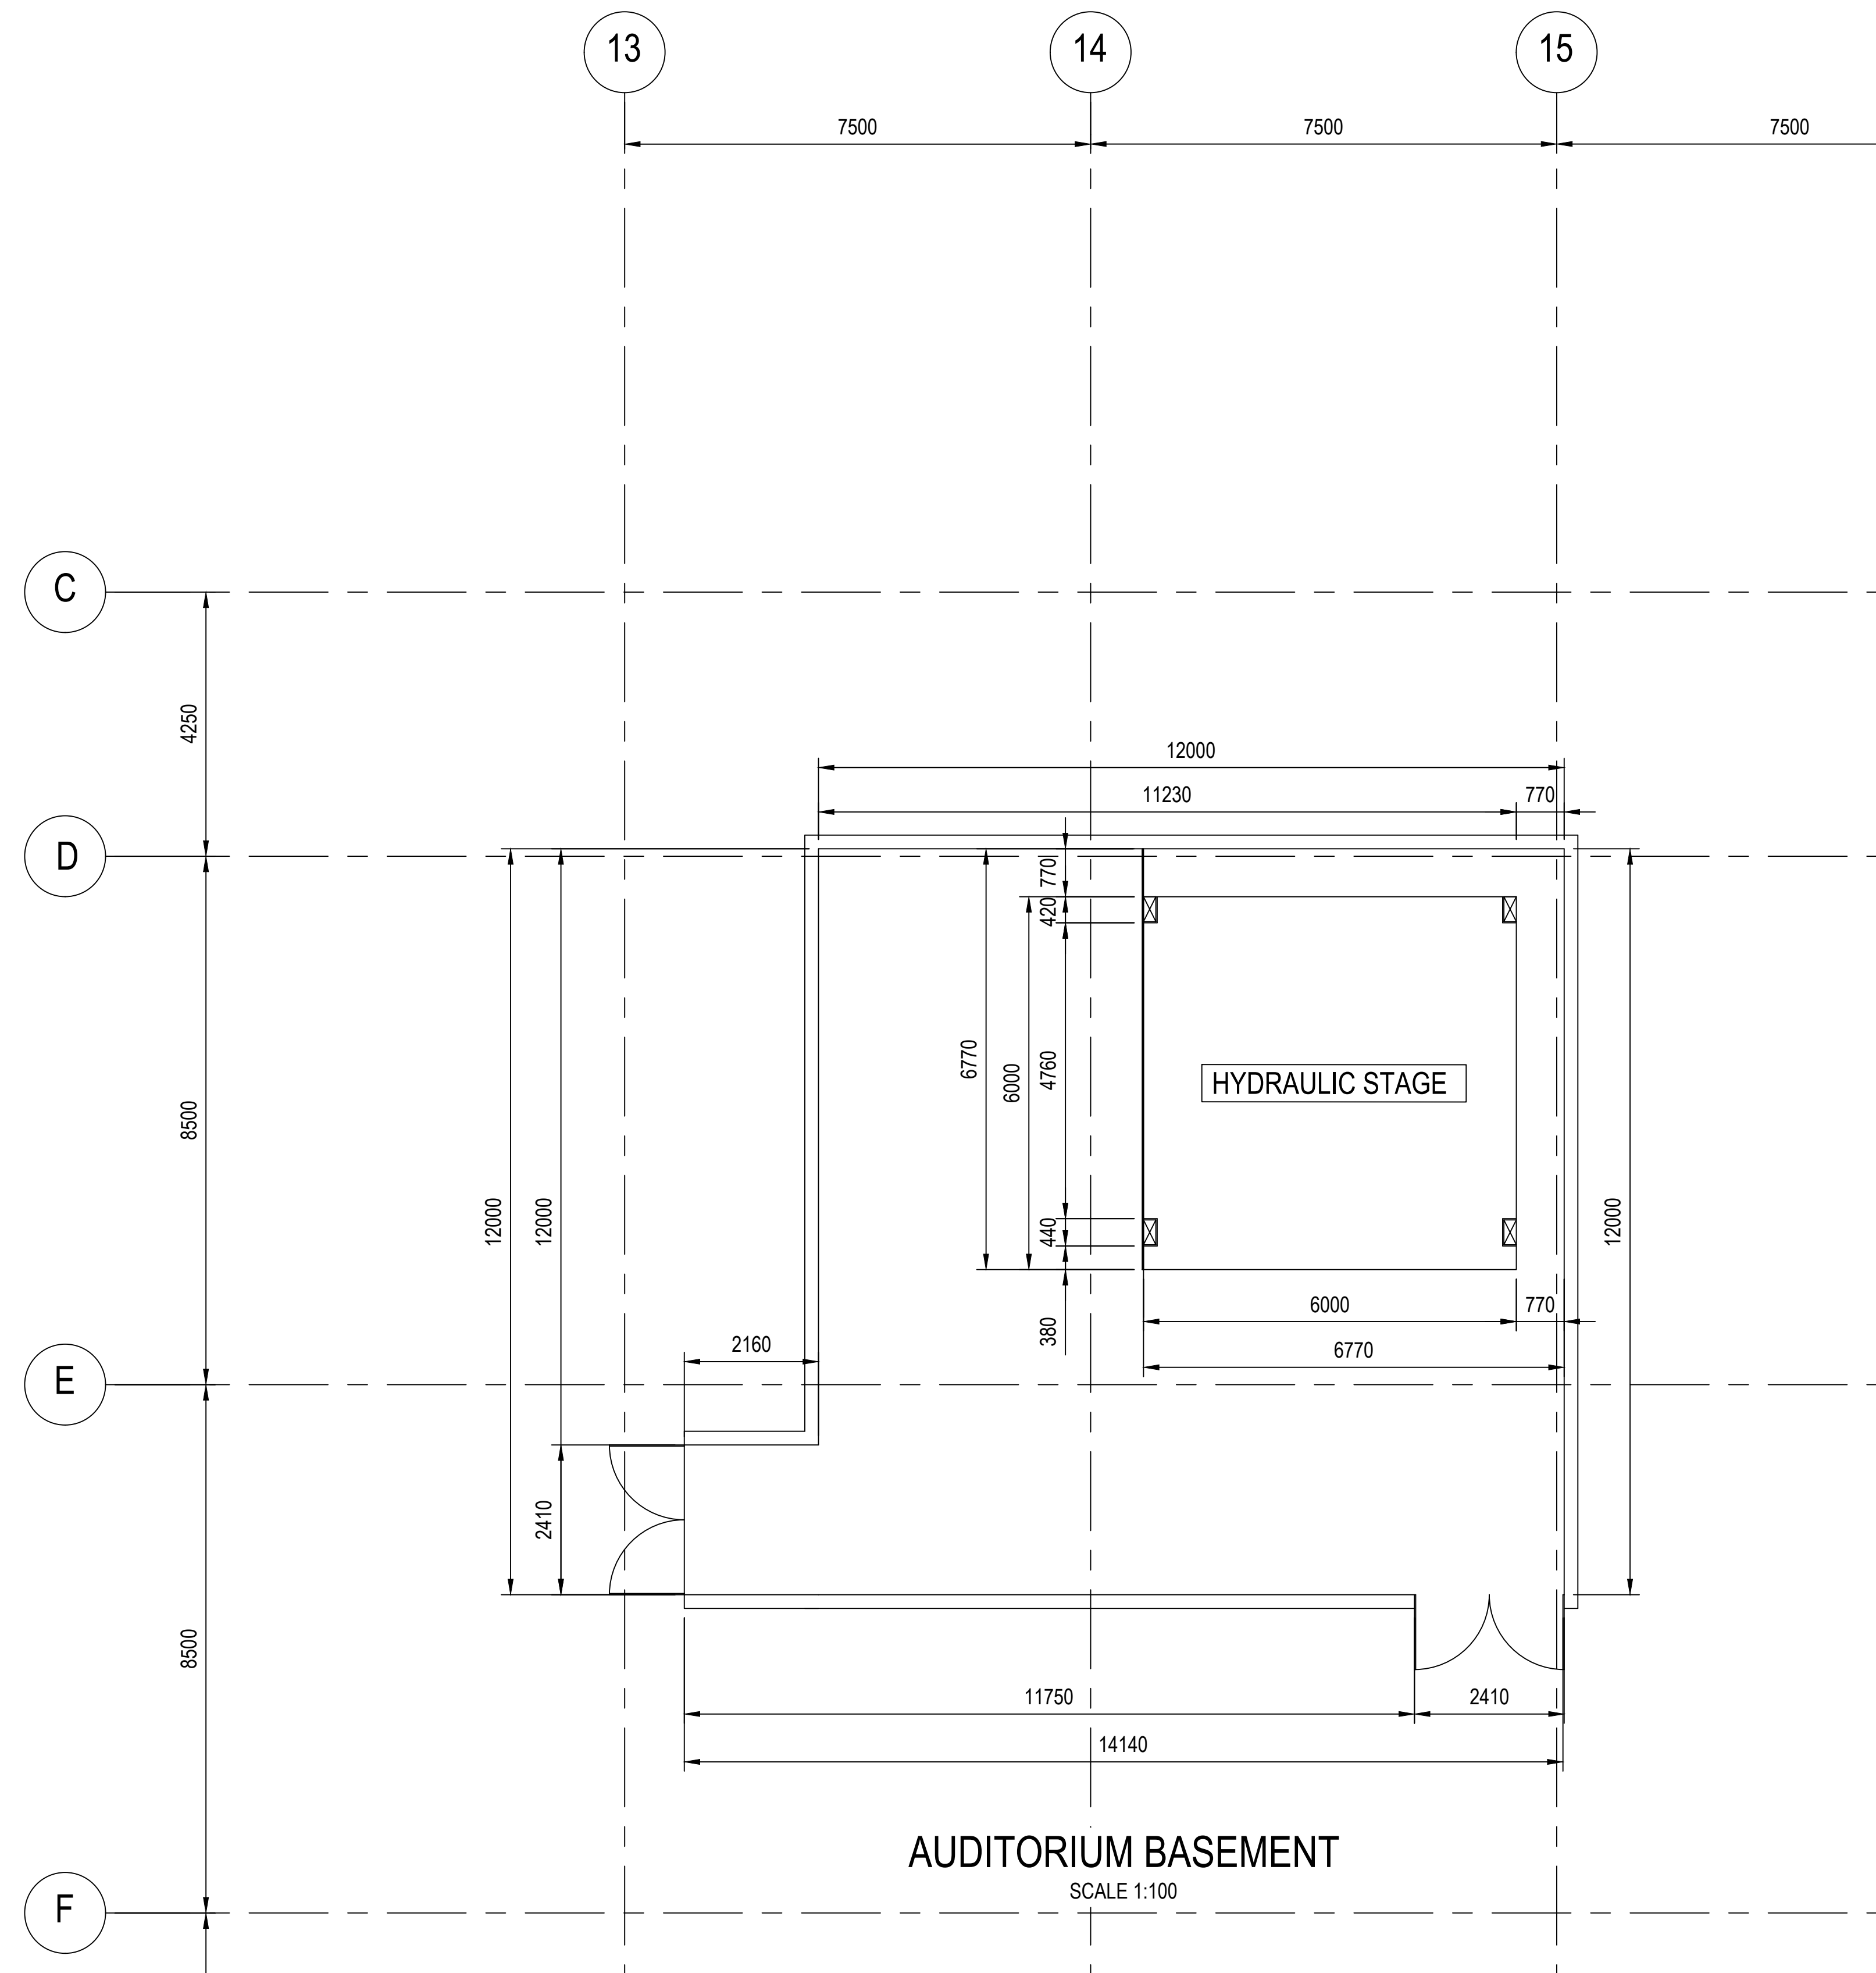

AUDITORIUM BASEMENT
SCALE 1:100

NOTES:

REV	DATE	AMENDMENT
0	2025/07/04	ISSUED FOR INFORMATION

B *Boitshupelo*
CONSULTING ENGINEERS
OFFICE & Co. KYALAMI
134 RIVER Road
KYALAMI HEIGHTS
1684
Telephone: (011) 267 0583
Cellphone: 076 535 6970
email: thato@bmoleneconsulting.co.za



PROJECT
GALLAGHER CONVENTION CENTRE
AS BUILT DRAWINGS.

DRAWING TITLE
AUDITORIUM
AUDITORIUM BASEMENT

SCALE	AS SHOWN	DESIGNED	T.M
DATE	24/04/2025	DRAWN	T.M
REVISION	00	CHECKED	T.M

DRAWING NO. BTK025-MC-03 FOR AS BUILT